



V6

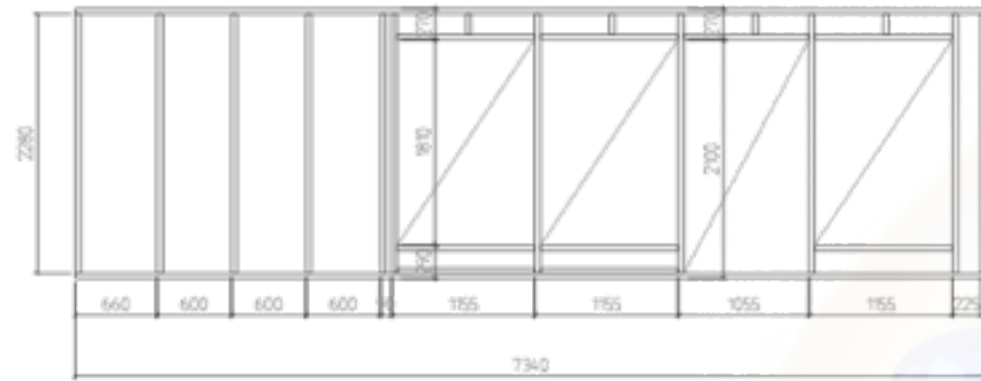


V5

RELATIONSHANDLINGAR		
SILJANSNÄS		
1:50		
ELEVATIONER V05-V06		
1:50	K20 4-103	

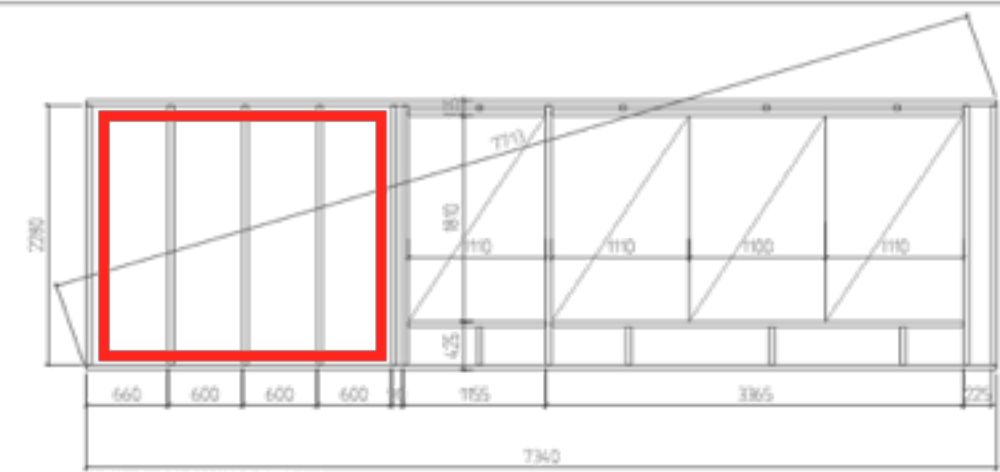

V6

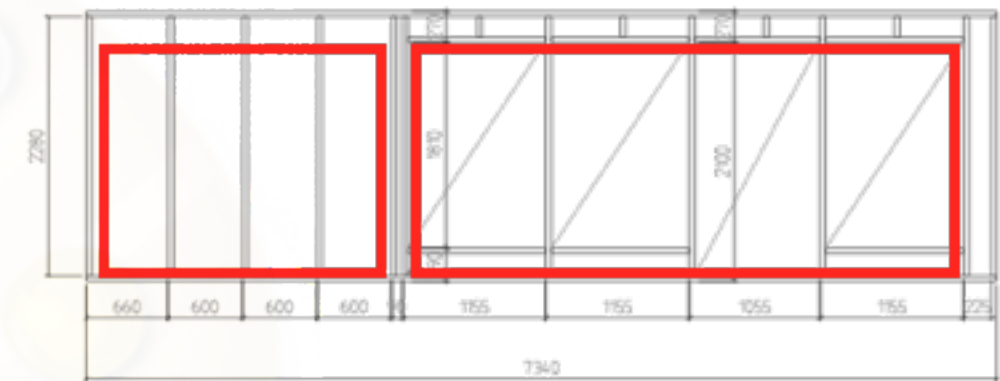

V5

RELATIONSHANDLINGAR		
SILJANSNÄS		
1:50		
ELEVATIONER V05-V06		
1:50	K20 4-103	



Created by Paint S

