


V9

ANTAL = 2

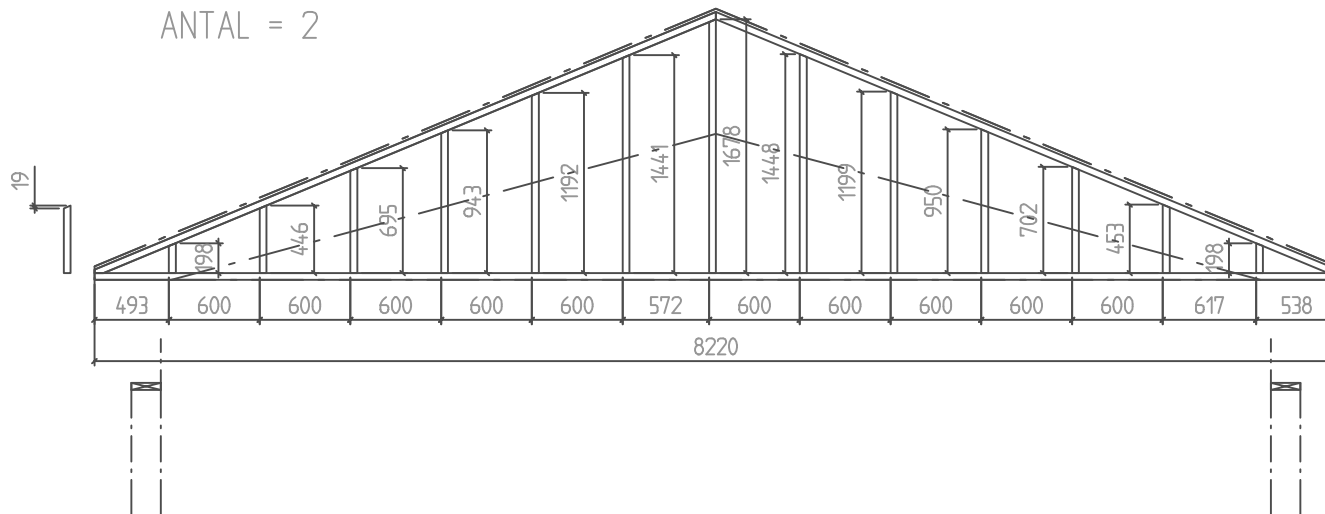

BET.	INR.	BEROENHANSOR	DATA	SKRI
STATUS RELATIONSHANDLINGAR				
PROJEKT SILJANSNÄS				
ARB. NR.				
RITADKONTROLLAV.		HÄNDELLOGGARE		
MHN		MHN		
DATA				
130405		REVISORER		
NYBYGGNAD FRITIDSHUS				
ELEVATIONER V09				
SKALA		RITNINGAR		BST.
1: 50		K20.4-105		